





Description **Plaza District Pre-Built Office Space**

As Built Floorplan

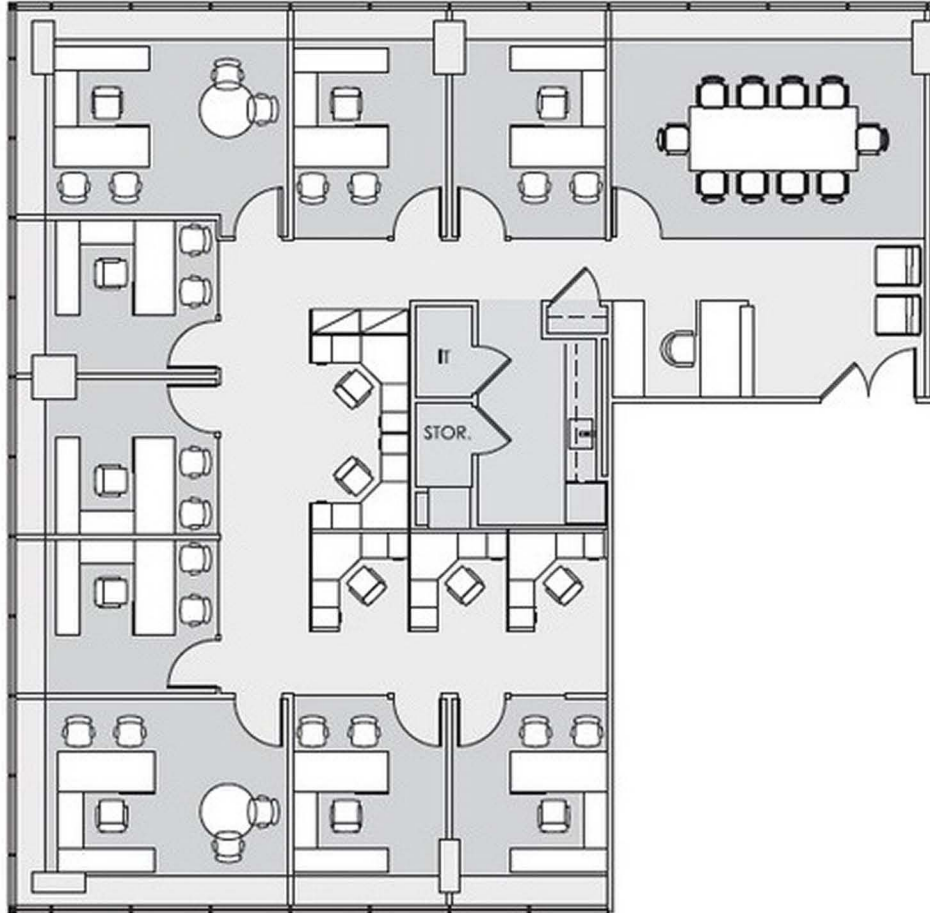

FLOOR KEY	
Offices	9
Corner Offices	2
Conference Room	1
Workstations	5
Pantry/Storage	1
Total	15

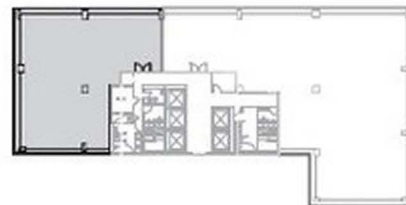

For Further Information, Please Contact

Todd Abrams
Prime Manhattan Realty
646-485-5886 - direct
212-729-6559 - cell